





As Built
Suite 410
18,362 RSF

Three Coliseum
Centre
2550 W. Tyvola Road
Charlotte, NC

Joe Franco
704.331.1241
Joe.Franco@cbre.com

Stephanie Spivey
704.331.1298
Stephanie.Spivey@cbre.com

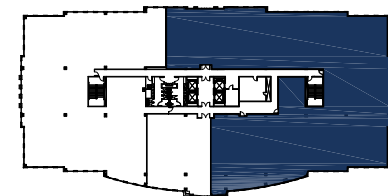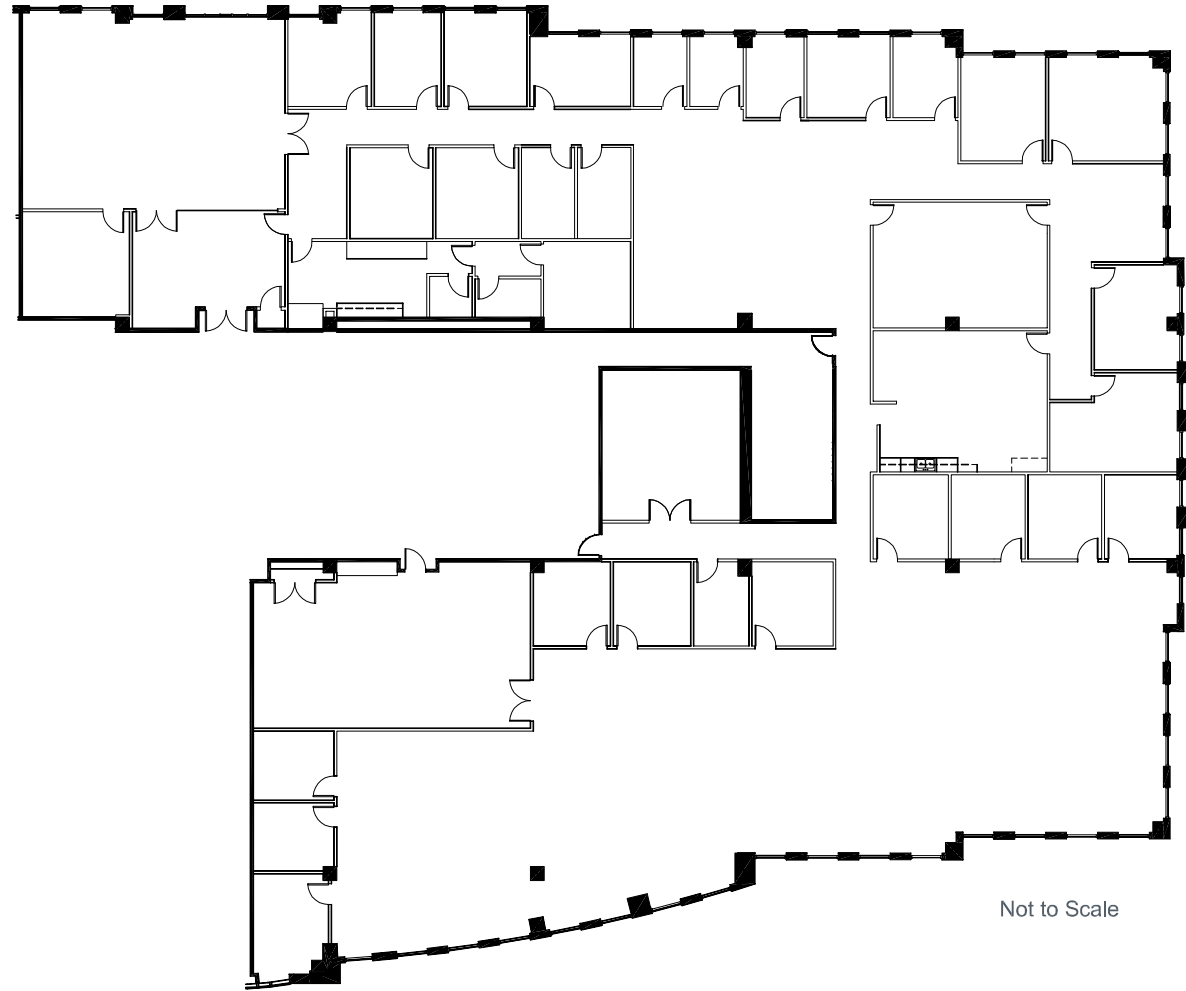

Key Plan



*This suite has not been field surveyed by NELSON

